

I CERTIFY THAT THIS PLAN SHOWS THE UNIT BEING CONVEYED AND IMMEDIATELY ADJOINING UNITS AS BUILT WITH APPROXIMATE BUILDING AREA, MAIN ENTRANCE, AND IMMEDIATE COMMON AREAS TO WHICH IT HAS ACCESS AND CONFORMING WITH THE RULES AND REGULATIONS OF THE REGISTERS OF DEEDS IN PREPARING THE PLAN


1/8" = 1'-0"



UNIT ANALYSIS  
 958 SQ. FT.  
 11.7% FLOOR OWNERSHIP

BERNARD J. GOBA, AIA

DATE

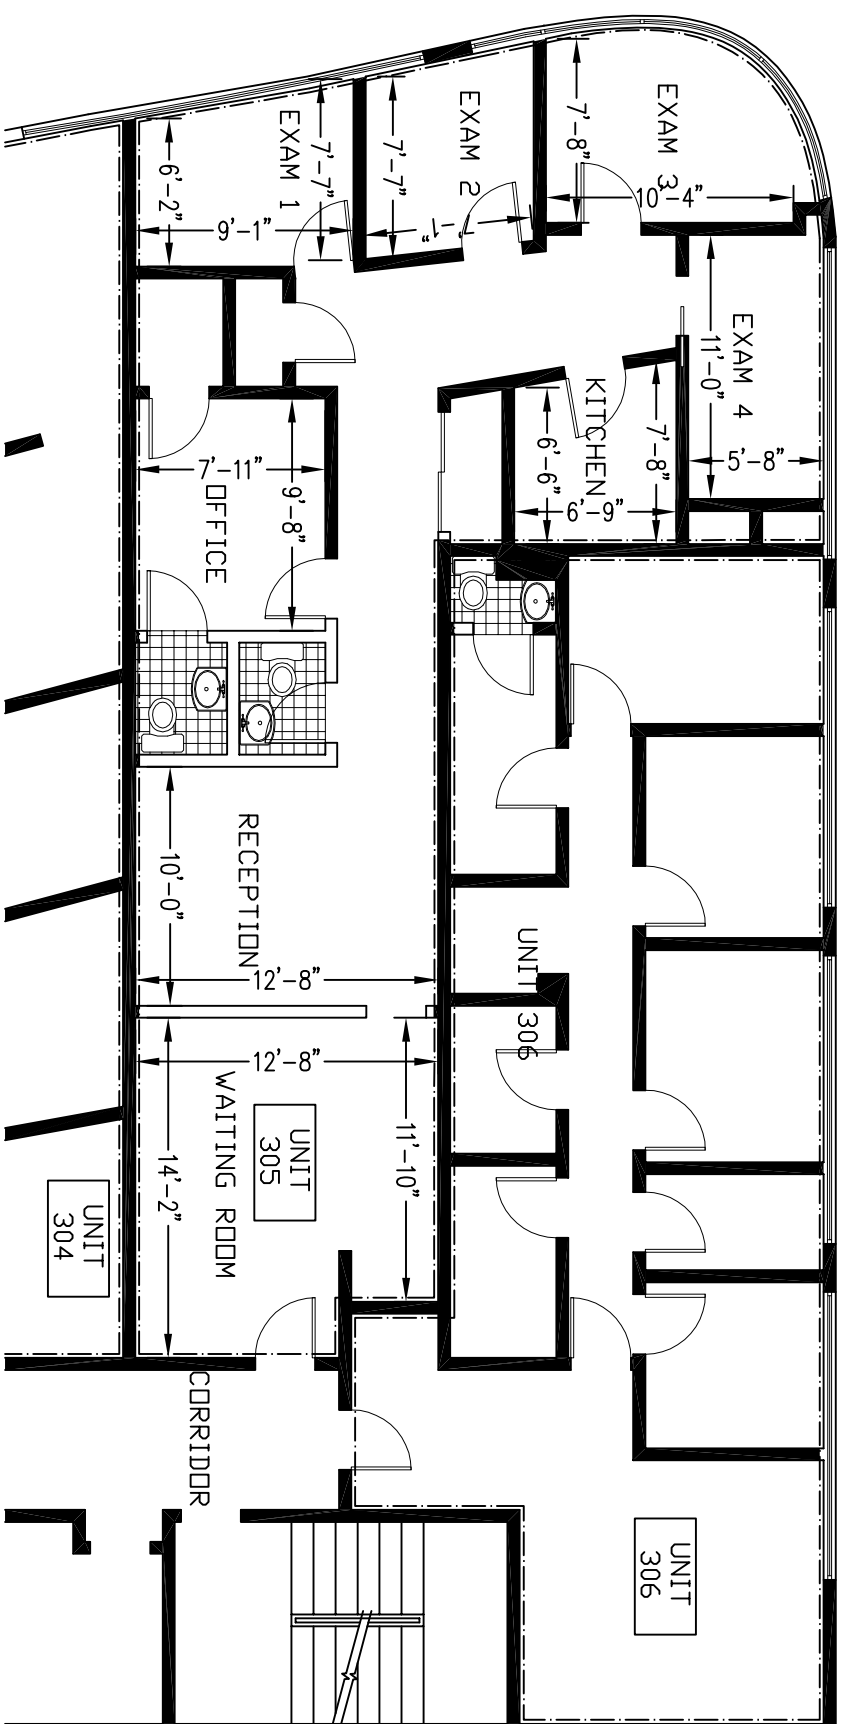

B. GOBA &  
 ASSOCIATES P.C.  
 ARCHITECTS  
 SUITE 1-41  
 92 HIGH STREET  
 MEDFORD, MA  
 02155  
 (781) 395-2827

REVISIONS

BEACON 1842 CONDOMINIUM TRUST  
 1842 BEACON STREET  
 BROOKLINE, MA

DATE PLOTTED:  
 JAN 15, 2010

THIRD FLOOR  
 UNIT 305

1/8" = 1'-0"

DRAWN BY: RDH

CHECKED BY: BG